

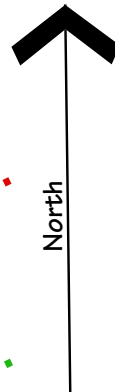


Pension Mountain Trails City of Berryville

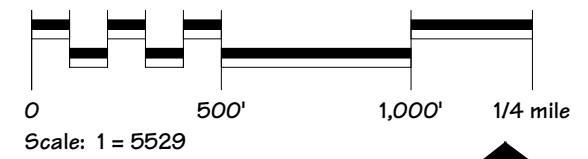

- non-motorized,
single track
 - existing
 - proposed
- motorized,
4' track
 - existing
 - proposed

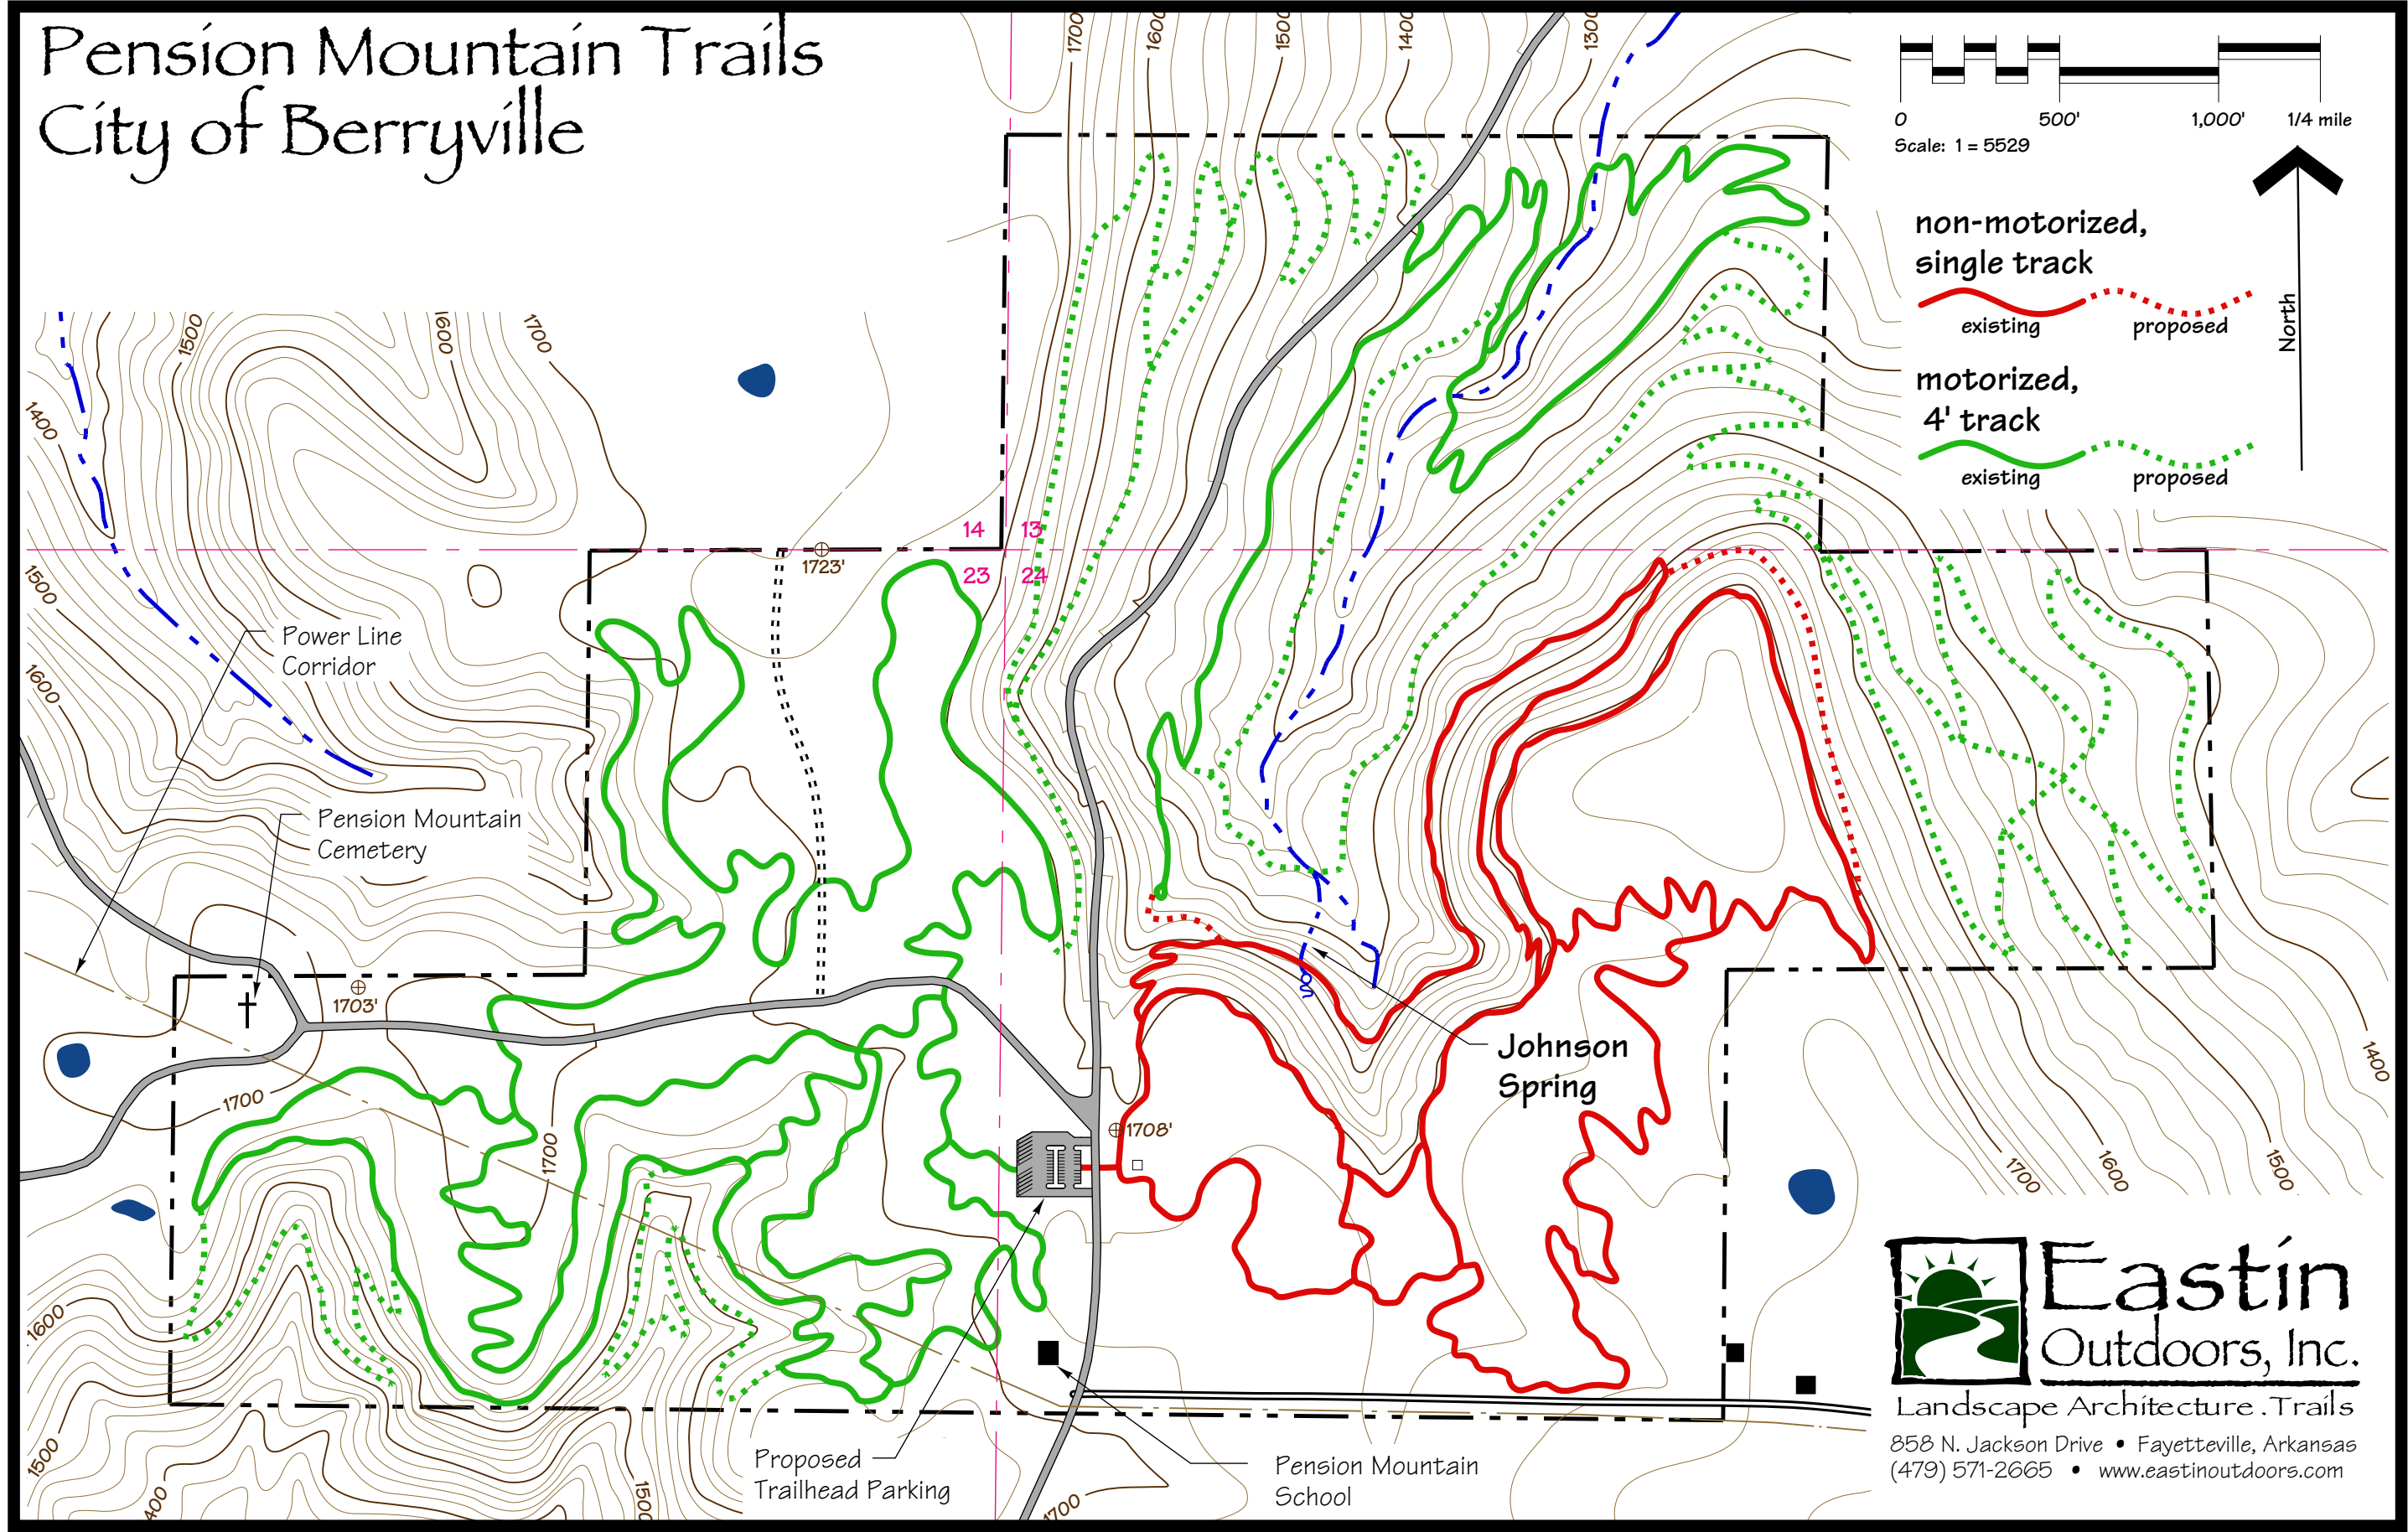

Landscape Architecture . Trails
858 N. Jackson Drive • Fayetteville, Arkansas
(479) 571-2665 • www.eastinoutdoors.com